Remove existing emergent aquatic vegetation in Pond 7. See Attachment V.

Remove emergent aquatic vegetation in channel. See Attachment IV.

Remove emergent aquatic vegetation in Pond 3. See Attachment V.

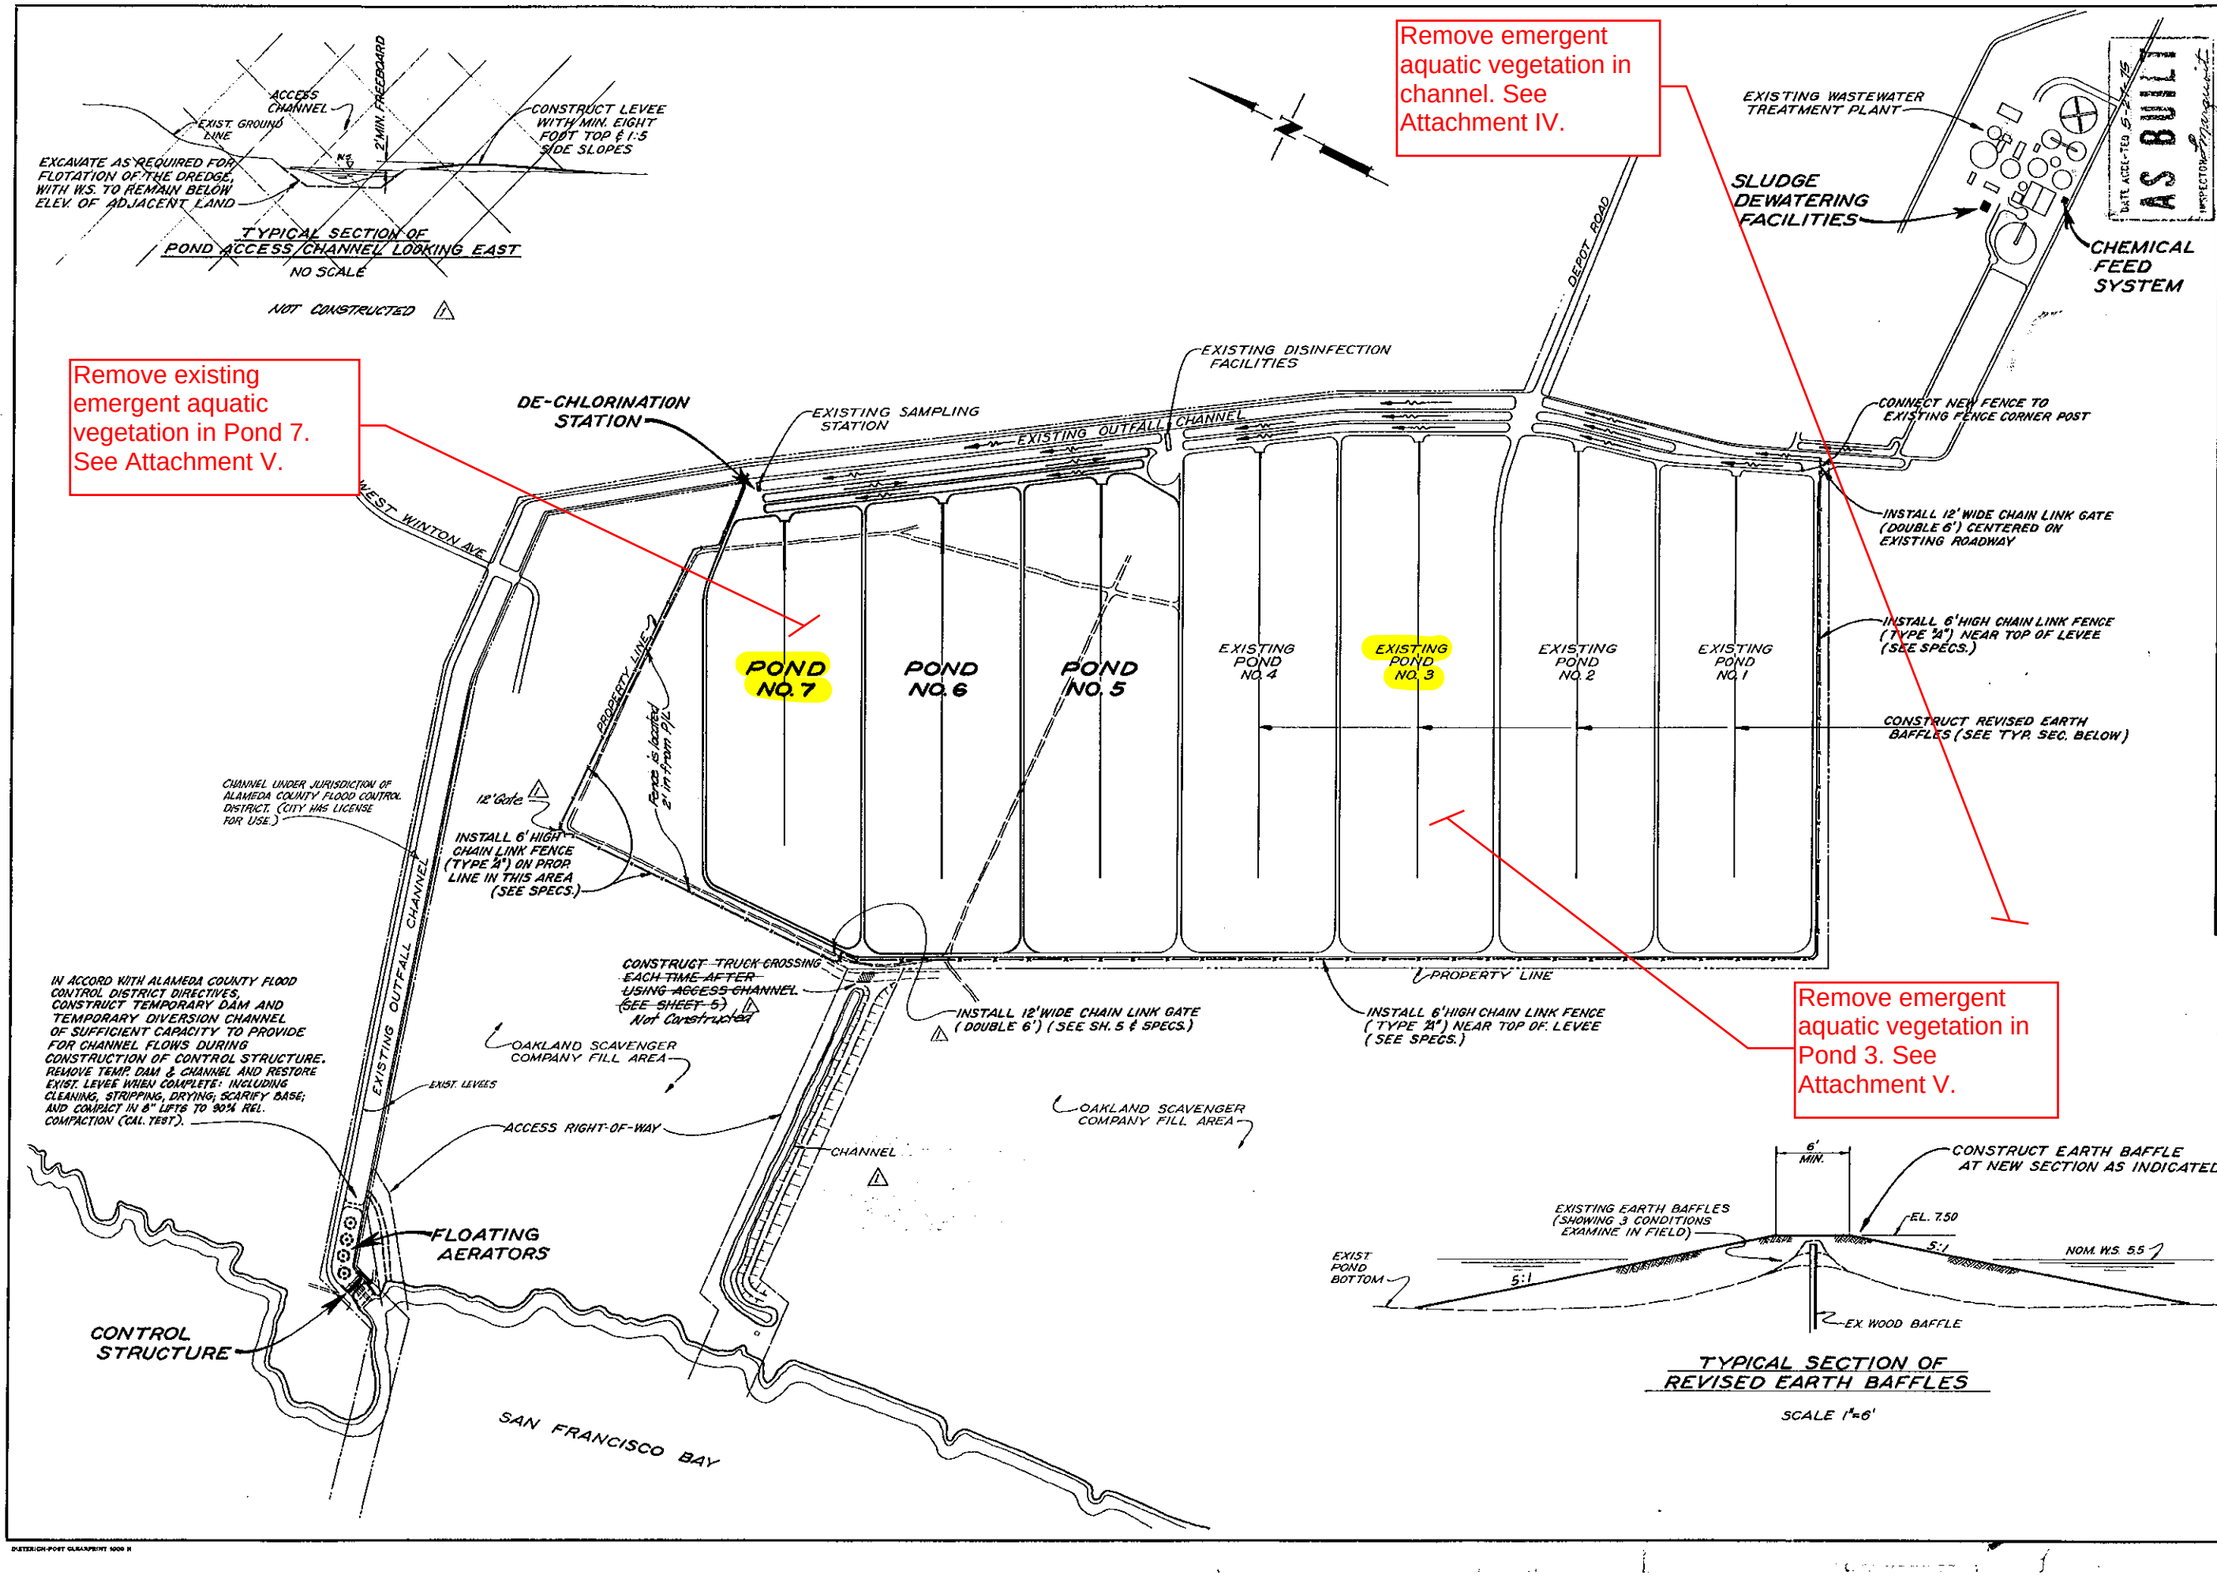

TYPICAL SECTION OF REVISED EARTH BAFFLES

SCALE 1"=6'

AS BUILT
DATE ACCEPTED 5-24-76
INSPECTOR [illegible]

CITY OF HAYWARD
PUBLIC WORKS DEPARTMENT
ENGINEERING DIVISION

DESIGNED BY: RCE-DAB
DRAWN BY: SLH
CHECKED BY: JHJ
APPROVAL RECOM.: JHJ
APPROVED BY: [signature] CITY ENGR.
DATE: APRIL 1972
PROJ. NO.: 48 051

NO.	DATE	DESCRIPTION	BY
1	6-23-76	As Built	LSP

WASTEWATER TREATMENT AND DISPOSAL FACILITIES STAGE II
OXIDATION PONDS
SITE PLAN

SCALE: 1"=300' EXCEPT AS NOTED
TOTAL SHEETS: 27 #1
FILE NO.: E 680
SHEET NO. 2

JENKS & ADAMSON
CONSULTING SANITARY ENGINEERS
PALO ALTO CALIFORNIA

2-4-41

2

PATTERSON-POST GUARANTEE 1000 H